



SECTION B-B
SCALE 1" = 5'-0"

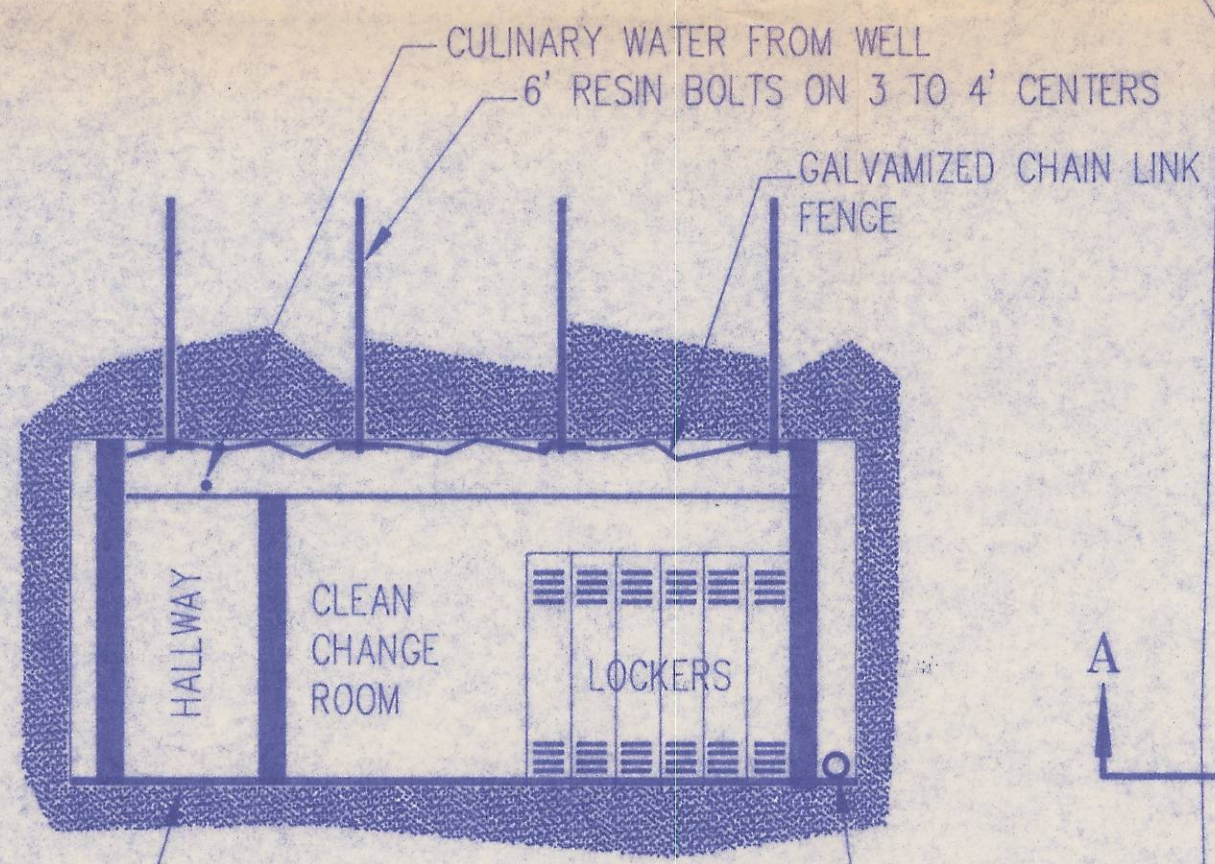

SECTION A-A
SCALE 1" = 5'-0"



PLATE 5-18

		GENWAL COAL CO.	
		P.O. BOX 1201 HUNTINGTON, UTAH 84528	
UNDERGROUND BATH HOUSE (AS BUILT)			
DRAWN BY:	LJ	REV. DATE:	12/23/92
DATE:	7/16/92	PLOT SCALE:	1"=10'
SCALE:	1"=10'	ACAD FILE NO.:	
DRAWING NO.:	C:\DWG\ARCH\BTHHSE.DWG		